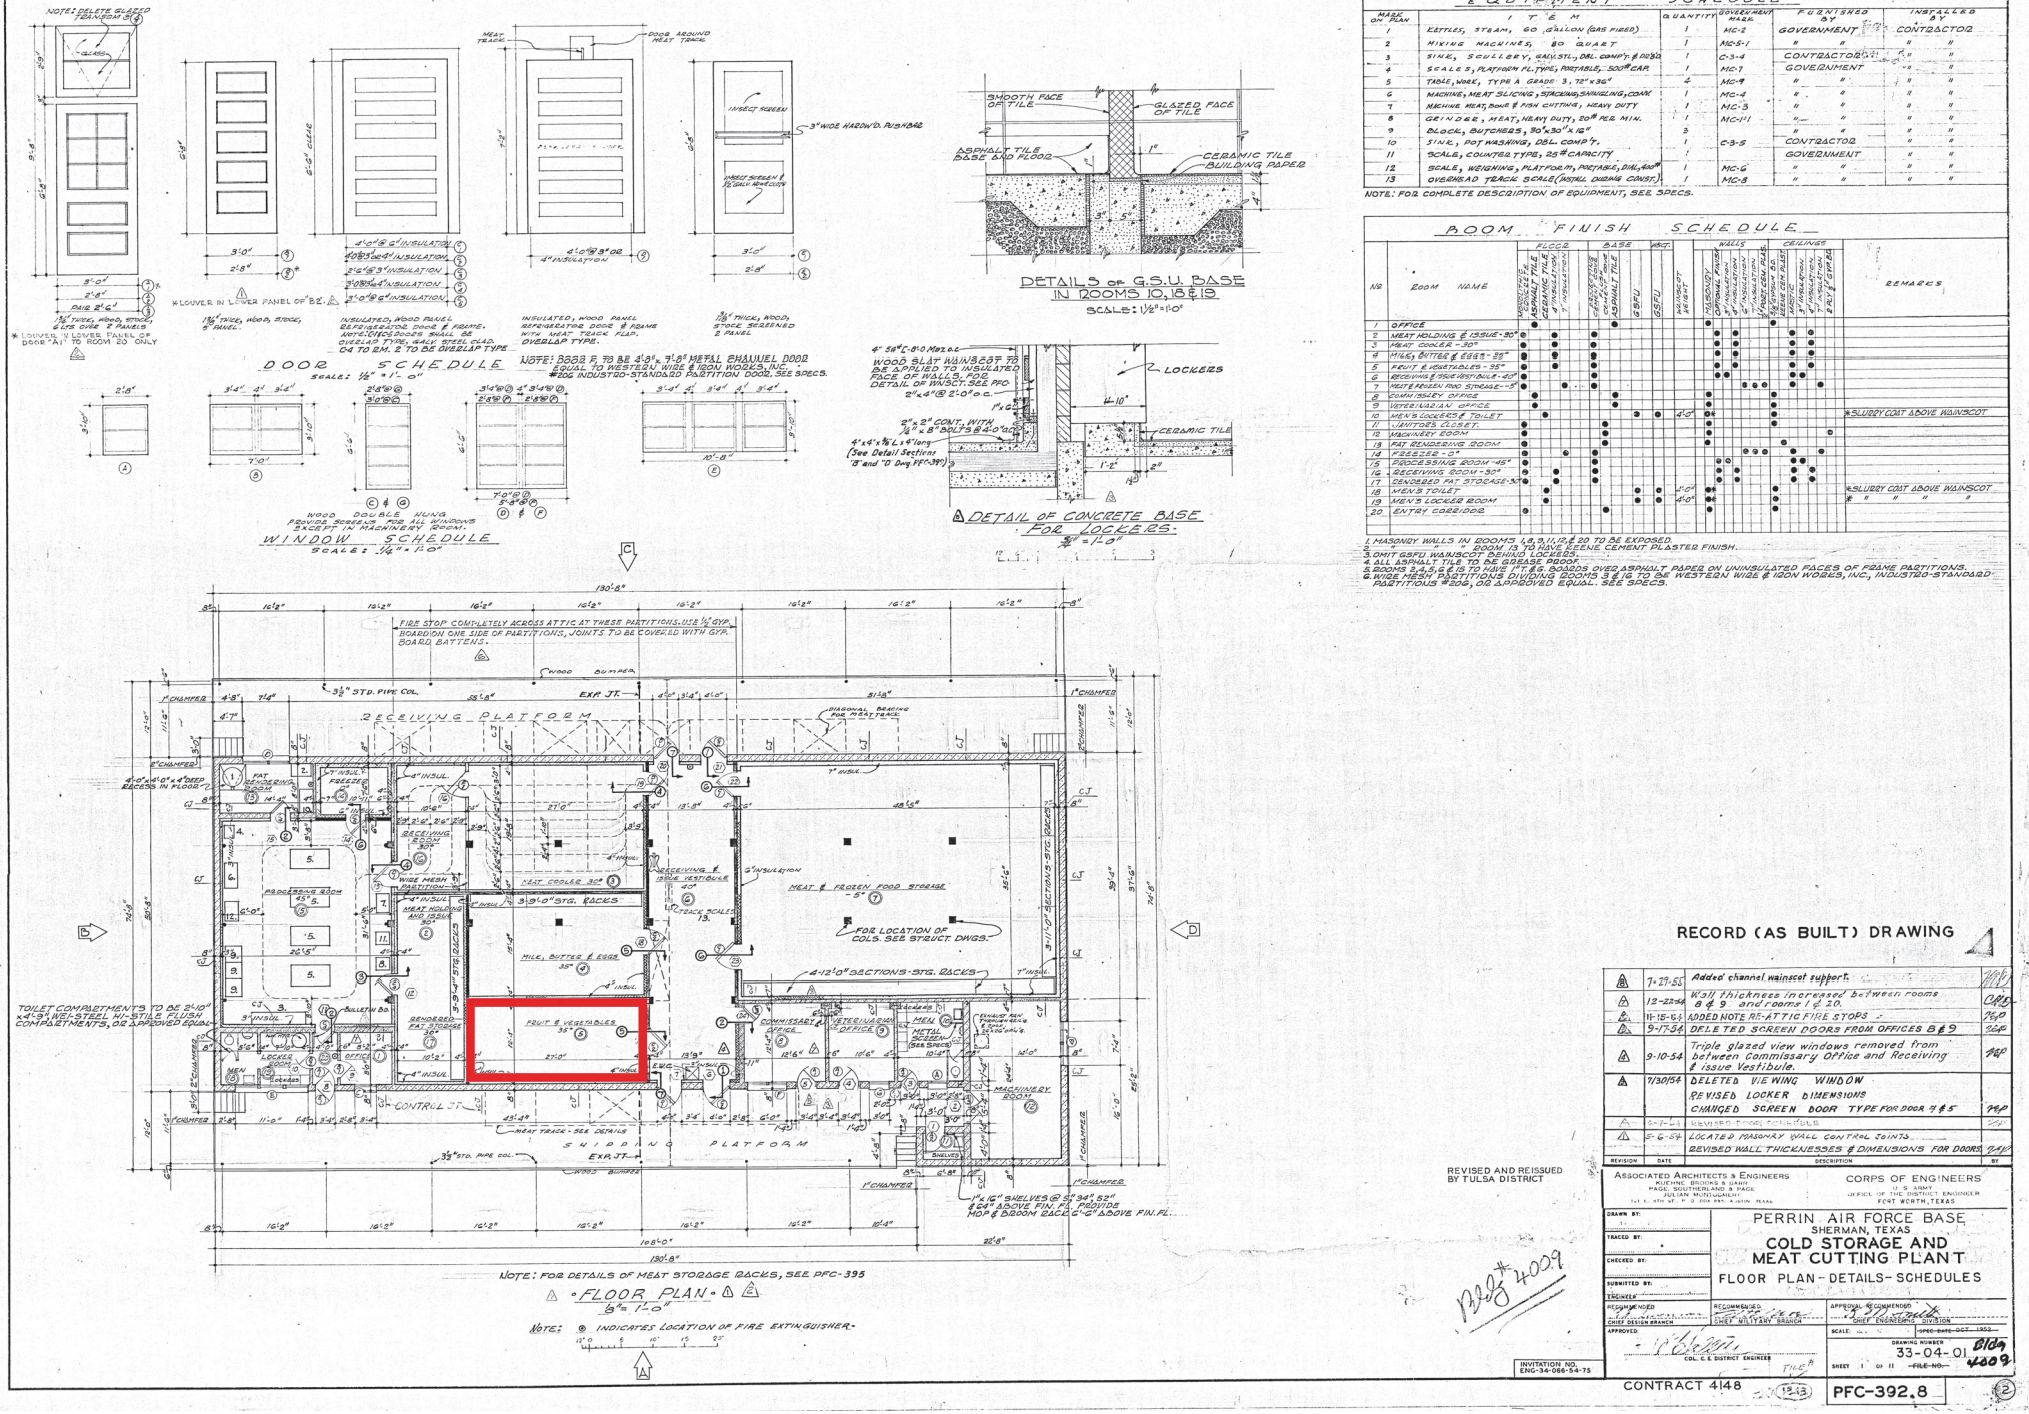

EQUIPMENT SCHEDULE

MARK ON PLAN	ITEM	QUANTITY	GOVERNMENT MARK	FURNISHED BY	INSTALLED BY
1	KETTLES, STEAM, 60 GALLON (GAS FIRED)	1	MC-2	GOVERNMENT	CONTRACTOR
2	MIXING MACHINES, 80 QUART	1	MC-5-1	" "	" "
3	SINK, SCULLERY, GALV. STL., DBL. COMP'T. & DRSG	1	C-3-4	CONTRACTOR	" "
4	SCALES, PLATFORM TYPE, PORTABLE, 500# CAP.	1	MC-7	GOVERNMENT	" "
5	TABLE, WORK, TYPE A GRADE 3, 72" x 36"	4	MC-9	" "	" "
6	MACHINE, MEAT SLICING, STACKING, SHINGLING, COMB.	1	MC-4	" "	" "
7	MACHINE MEAT, BONE & FISH CUTTING, HEAVY DUTY	1	MC-3	" "	" "
8	GRINDER, MEAT, HEAVY DUTY, 20# PER MIN.	1	MC-11	" "	" "
9	BLOCK, BUTCHERS, 30" x 30" x 12"	3		" "	" "
10	SINK, POT WASHING, DBL. COMP'T.	1	C-3-5	CONTRACTOR	" "
11	SCALE, COUNTER TYPE, 25# CAPACITY	1		GOVERNMENT	" "
12	SCALE, WEIGHING, PLATFORM, PORTABLE, DIAL, 400#	1	MC-6	" "	" "
13	OVERHEAD TRACK SCALE (INSTALL DURING CONST.)	1	MC-8	" "	" "

NOTE: FOR COMPLETE DESCRIPTION OF EQUIPMENT, SEE SPECS.

ROOM FINISH SCHEDULE

NO	ROOM NAME	FLOOR: ASPHALT TILE	FLOOR: CERAMIC TILE	FLOOR: CONCRETE TROWEL FINISH	FLOOR: 1" INSULATION	BASE: CERAMIC TILE	BASE: ASPHALT TILE	BASE: GSFU	WAINSCT: MASONRY HEIGHT	WALLS: ASPHALT PAPER	WALLS: 4" INSULATION	WALLS: 8" CONC. BLK.	WALLS: 8" STRUC. CLAY TILE	WALLS: PLASTER	CEILINGS: 4" INSULATION	CEILINGS: 8" REINF. CONC. SLAB	CEILINGS: FIN. UNDERSIDE OF ROOF DECK	REMARKS
1	OFFICE		●				●							●			●	
2	MEAT HOLDING & ISSUE -30°	●				●				●	●			●			●	
3	MEAT COOLER -30°	●				●				●	●			●			●	
4	MILK, BUTTER & EGGS -35°	●				●				●	●			●			●	
5	FRUIT & VEGETABLES -35°	●				●				●	●			●			●	
6	RECEIVING & ISSUE VEST. & ALT -40°	●				●				●	●			●			●	
7	MEAT & FROZEN FOOD STORAGE -5°	●				●				●	●			●			●	
8	COMMISSARY OFFICE	●					●			●				●			●	
9	RECEIVING & ISSUE OFFICE	●					●			●				●			●	
10	MEN'S LOCKERS & TOILET	●					●		4'-0"	●				●			●	*SLURRY COAT ABOVE WAINSCOT
11	JANITOR'S CLOSET	●					●			●				●			●	
12	MACHINERY ROOM	●					●			●				●			●	
13	FAT RENDERING ROOM	●					●			●				●			●	
14	FREEZER -0°	●					●			●				●			●	
15	PROCESSING ROOM -45°	●					●			●				●			●	
16	RECEIVING ROOM -30°	●					●			●				●			●	
17	RENDERED FAT STORAGE-30°	●					●			●				●			●	
18	MEN'S TOILET	●					●		4'-0"	●				●			●	*SLURRY COAT ABOVE WAINSCOT
19	MEN'S LOCKER ROOM	●					●		4'-0"	●				●			●	" " " "
20	ENTRY CORRIDOR	●						●		●				●			●	

1. MASONRY WALLS IN ROOMS 1, 2, 3, 11, 12 & 20 TO BE EXPOSED.
2. " " " ROOM 19 TO HAVE TROWEL CEMENT PLASTER FINISH.
3. OMIT GSFU WAINSCOT BEHIND LOCKERS.
4. ALL ASPHALT TILE TO BE GREASE PROOF.
5. ROOMS 2, 4, 5, & 15 TO HAVE 1" x 6" S. BOARDS OVER ASPHALT PAPER ON UNINSULATED FACES OF FRAME PARTITIONS.
6. WIDE MESH PARTITIONS DIVIDING ROOMS 3 & 19 TO BE WESTERN WIRE & IRON WORKS, INC., INDUSTRO-STANDARD PARTITIONS #306, OR APPROVED EQUAL. SEE SPECS.

RECORD (AS BUILT) DRAWING

REVISION	DATE	DESCRIPTION	BY
6	7-27-55	Added channel wainscot support.	MVP
5	12-22-54	Wall thickness increased between rooms 8 & 9 and rooms 1 & 20.	CRP
4	11-15-54	ADDED NOTE RE-ATTIC FIRE STOPS	MVP
3	9-17-54	DELETED SCREEN DOORS FROM OFFICES 8 & 9	MVP
2	9-10-54	Triple glazed view windows removed from between Commissary Office and Receiving & Issue Vestibule.	MVP
1	7/30/54	DELETED VIEWING WINDOW REVISED LOCKER DIMENSIONS CHANGED SCREEN DOOR TYPE FOR DOOR 4 & 5	MVP
0	5-21-54	REVISED STORAGE RACKS	MVP
0	5-6-54	LOCATED MASONRY WALL CONTROL JOINTS	MVP
0	5-6-54	REVISED WALL THICKNESSES & DIMENSIONS FOR DOORS	MVP

REVISED AND REISSUED BY TULSA DISTRICT

ASSOCIATED ARCHITECTS & ENGINEERS
KUEHNE BROOKS & GANE
PAGE, SOUTHERLAND & PAGE
JULIAN MUNDGUCHIAN
1st E. 6th St. P. O. Box 881 Austin, Texas

CORPS OF ENGINEERS
U.S. ARMY
OFFICE OF THE DISTRICT ENGINEER
FORT WORTH, TEXAS

DRAWN BY:
TRACED BY:
CHECKED BY:
SUBMITTED BY:
ENGINEER
RECOMMENDED
CHIEF DESIGN BRANCH
APPROVED:
COL. C.E. DISTRICT ENGINEER

RECOMMENDED
CHIEF MILITARY BRANCH
APPROVAL RECOMMENDED
CHIEF ENGINEERING DIVISION

PERRIN AIR FORCE BASE
SHERMAN, TEXAS
COLD STORAGE AND MEAT CUTTING PLANT
FLOOR PLAN - DETAILS - SCHEDULES

SCALE: — SPEC. DWG. OCT. 1953
DRAWING NUMBER 33-04-01
SHEET 1 OF 11 FILE NO. Bldg 4209
INVITATION NO. ENG-34-066-54-75
CONTRACT 4148
PFC-392.8